



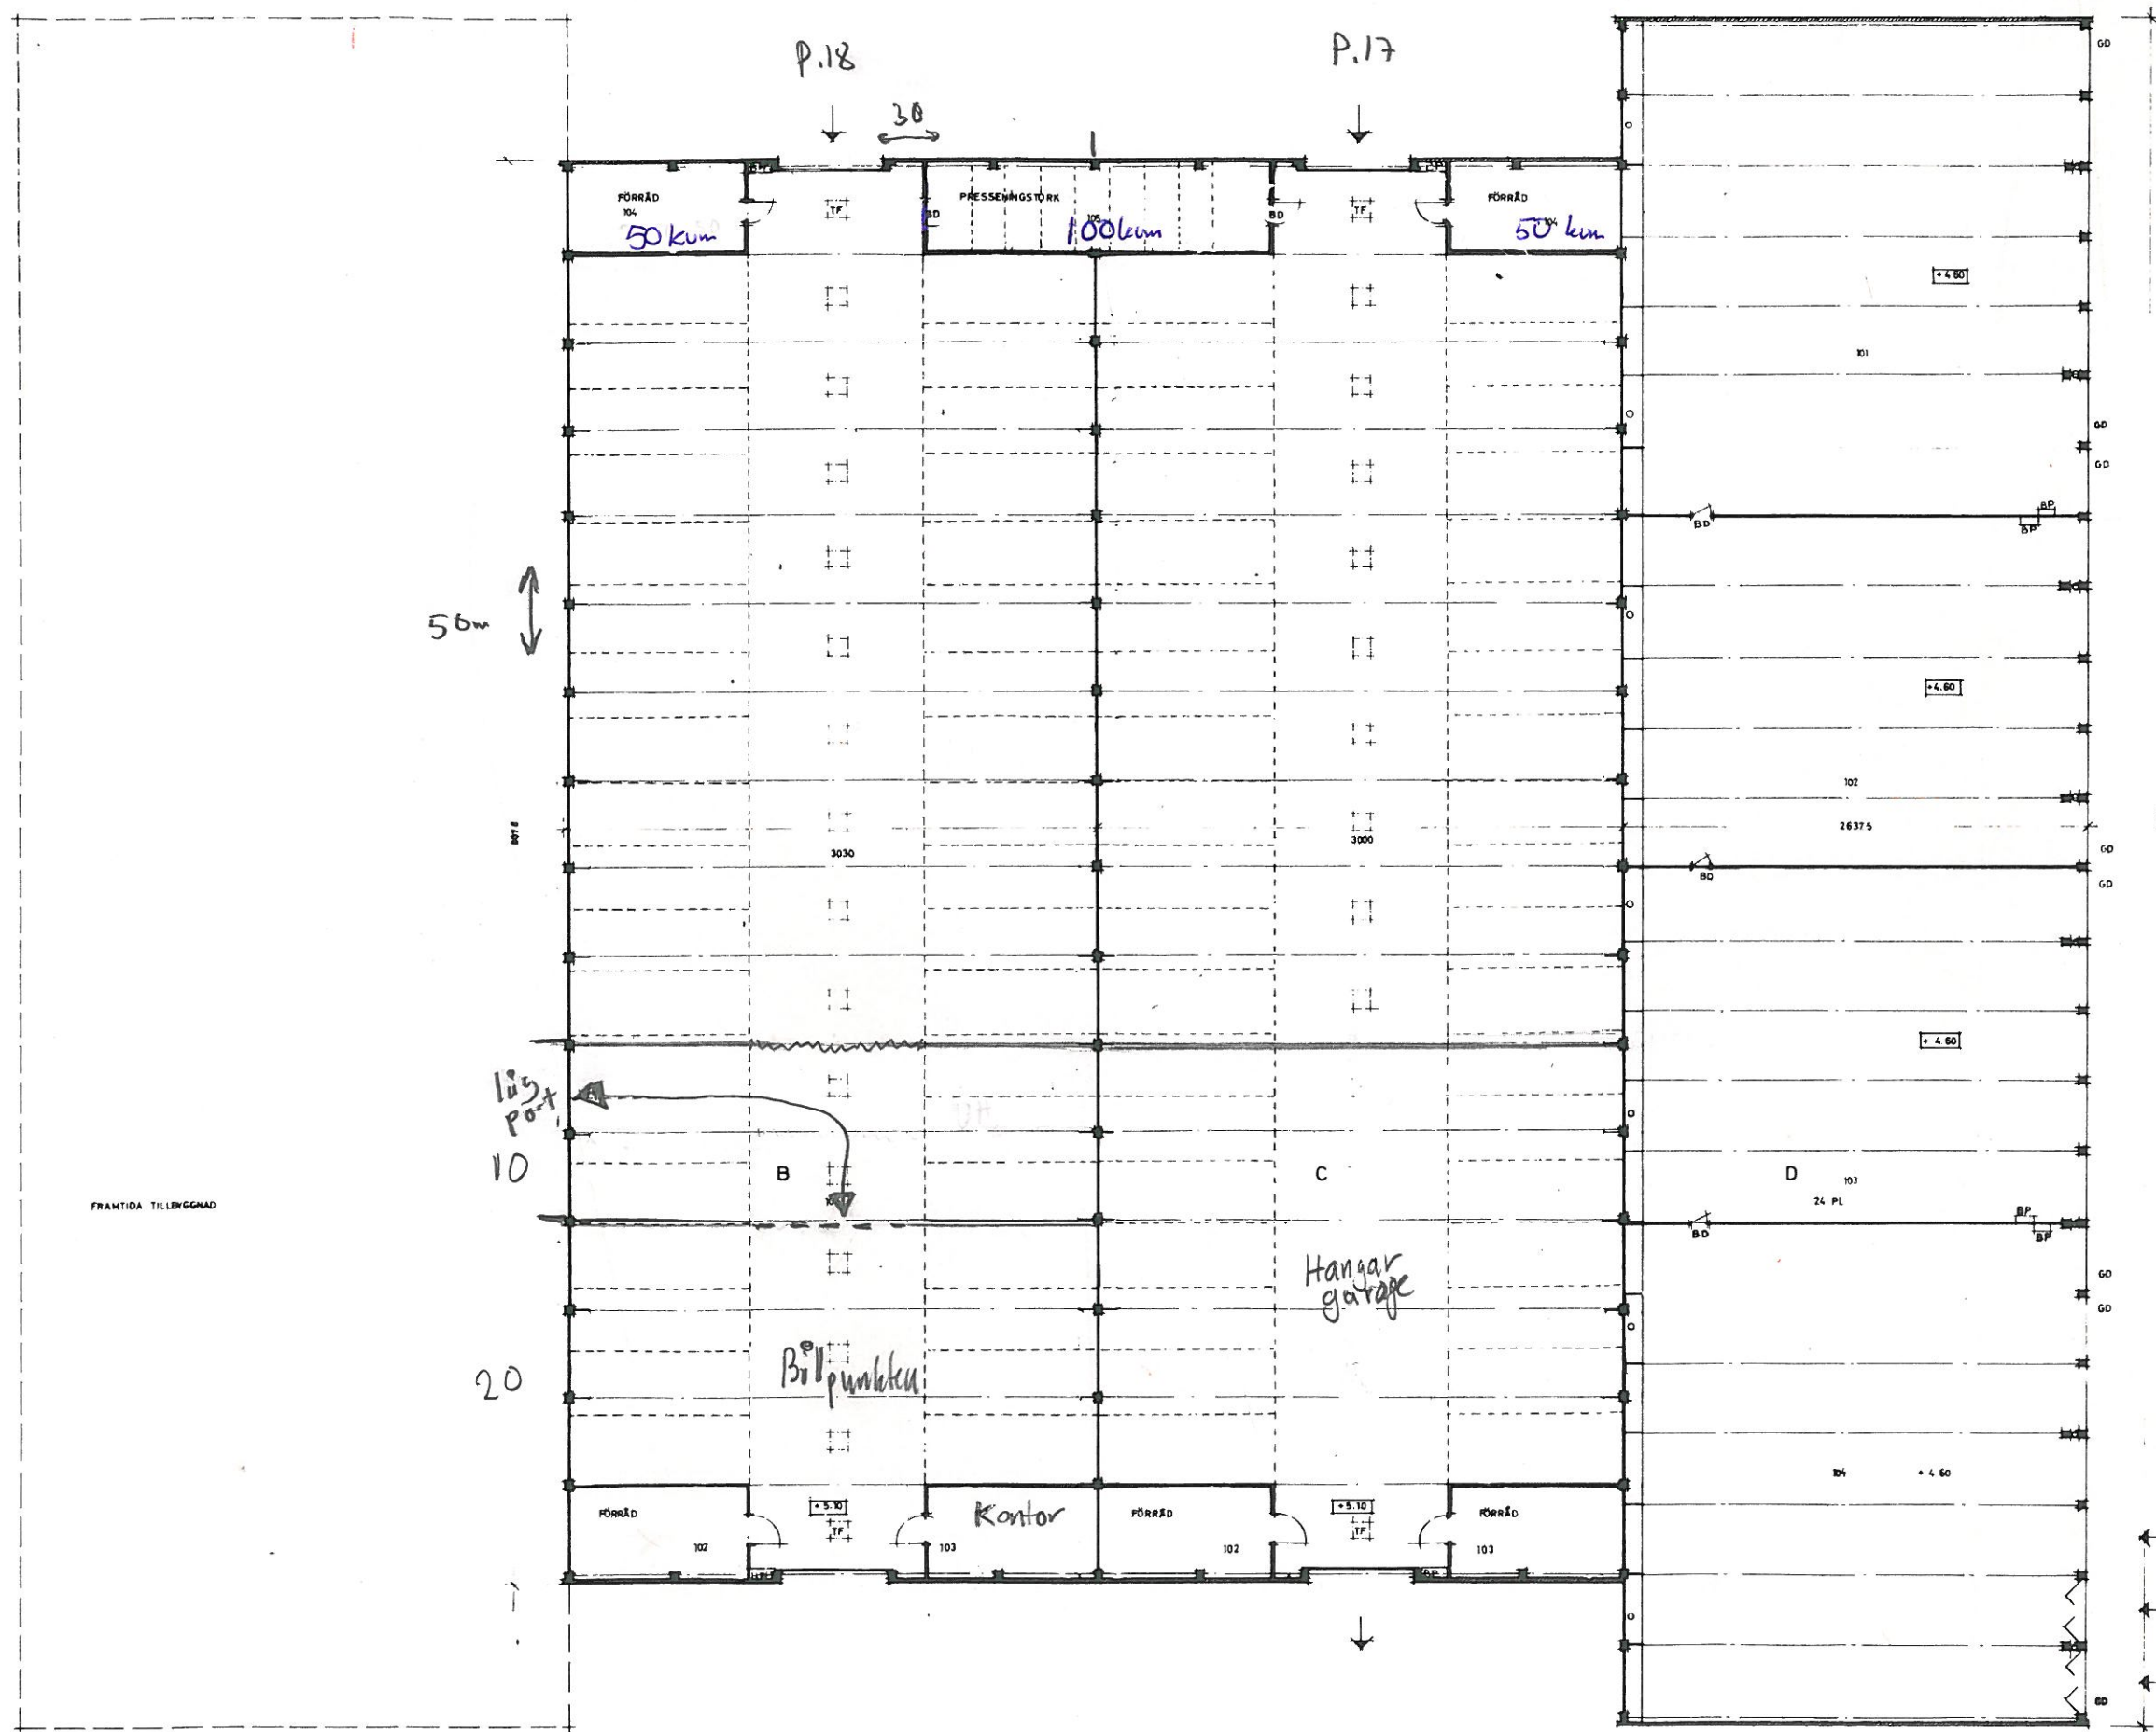

FRAMTIDA TILLBYGGNAD