


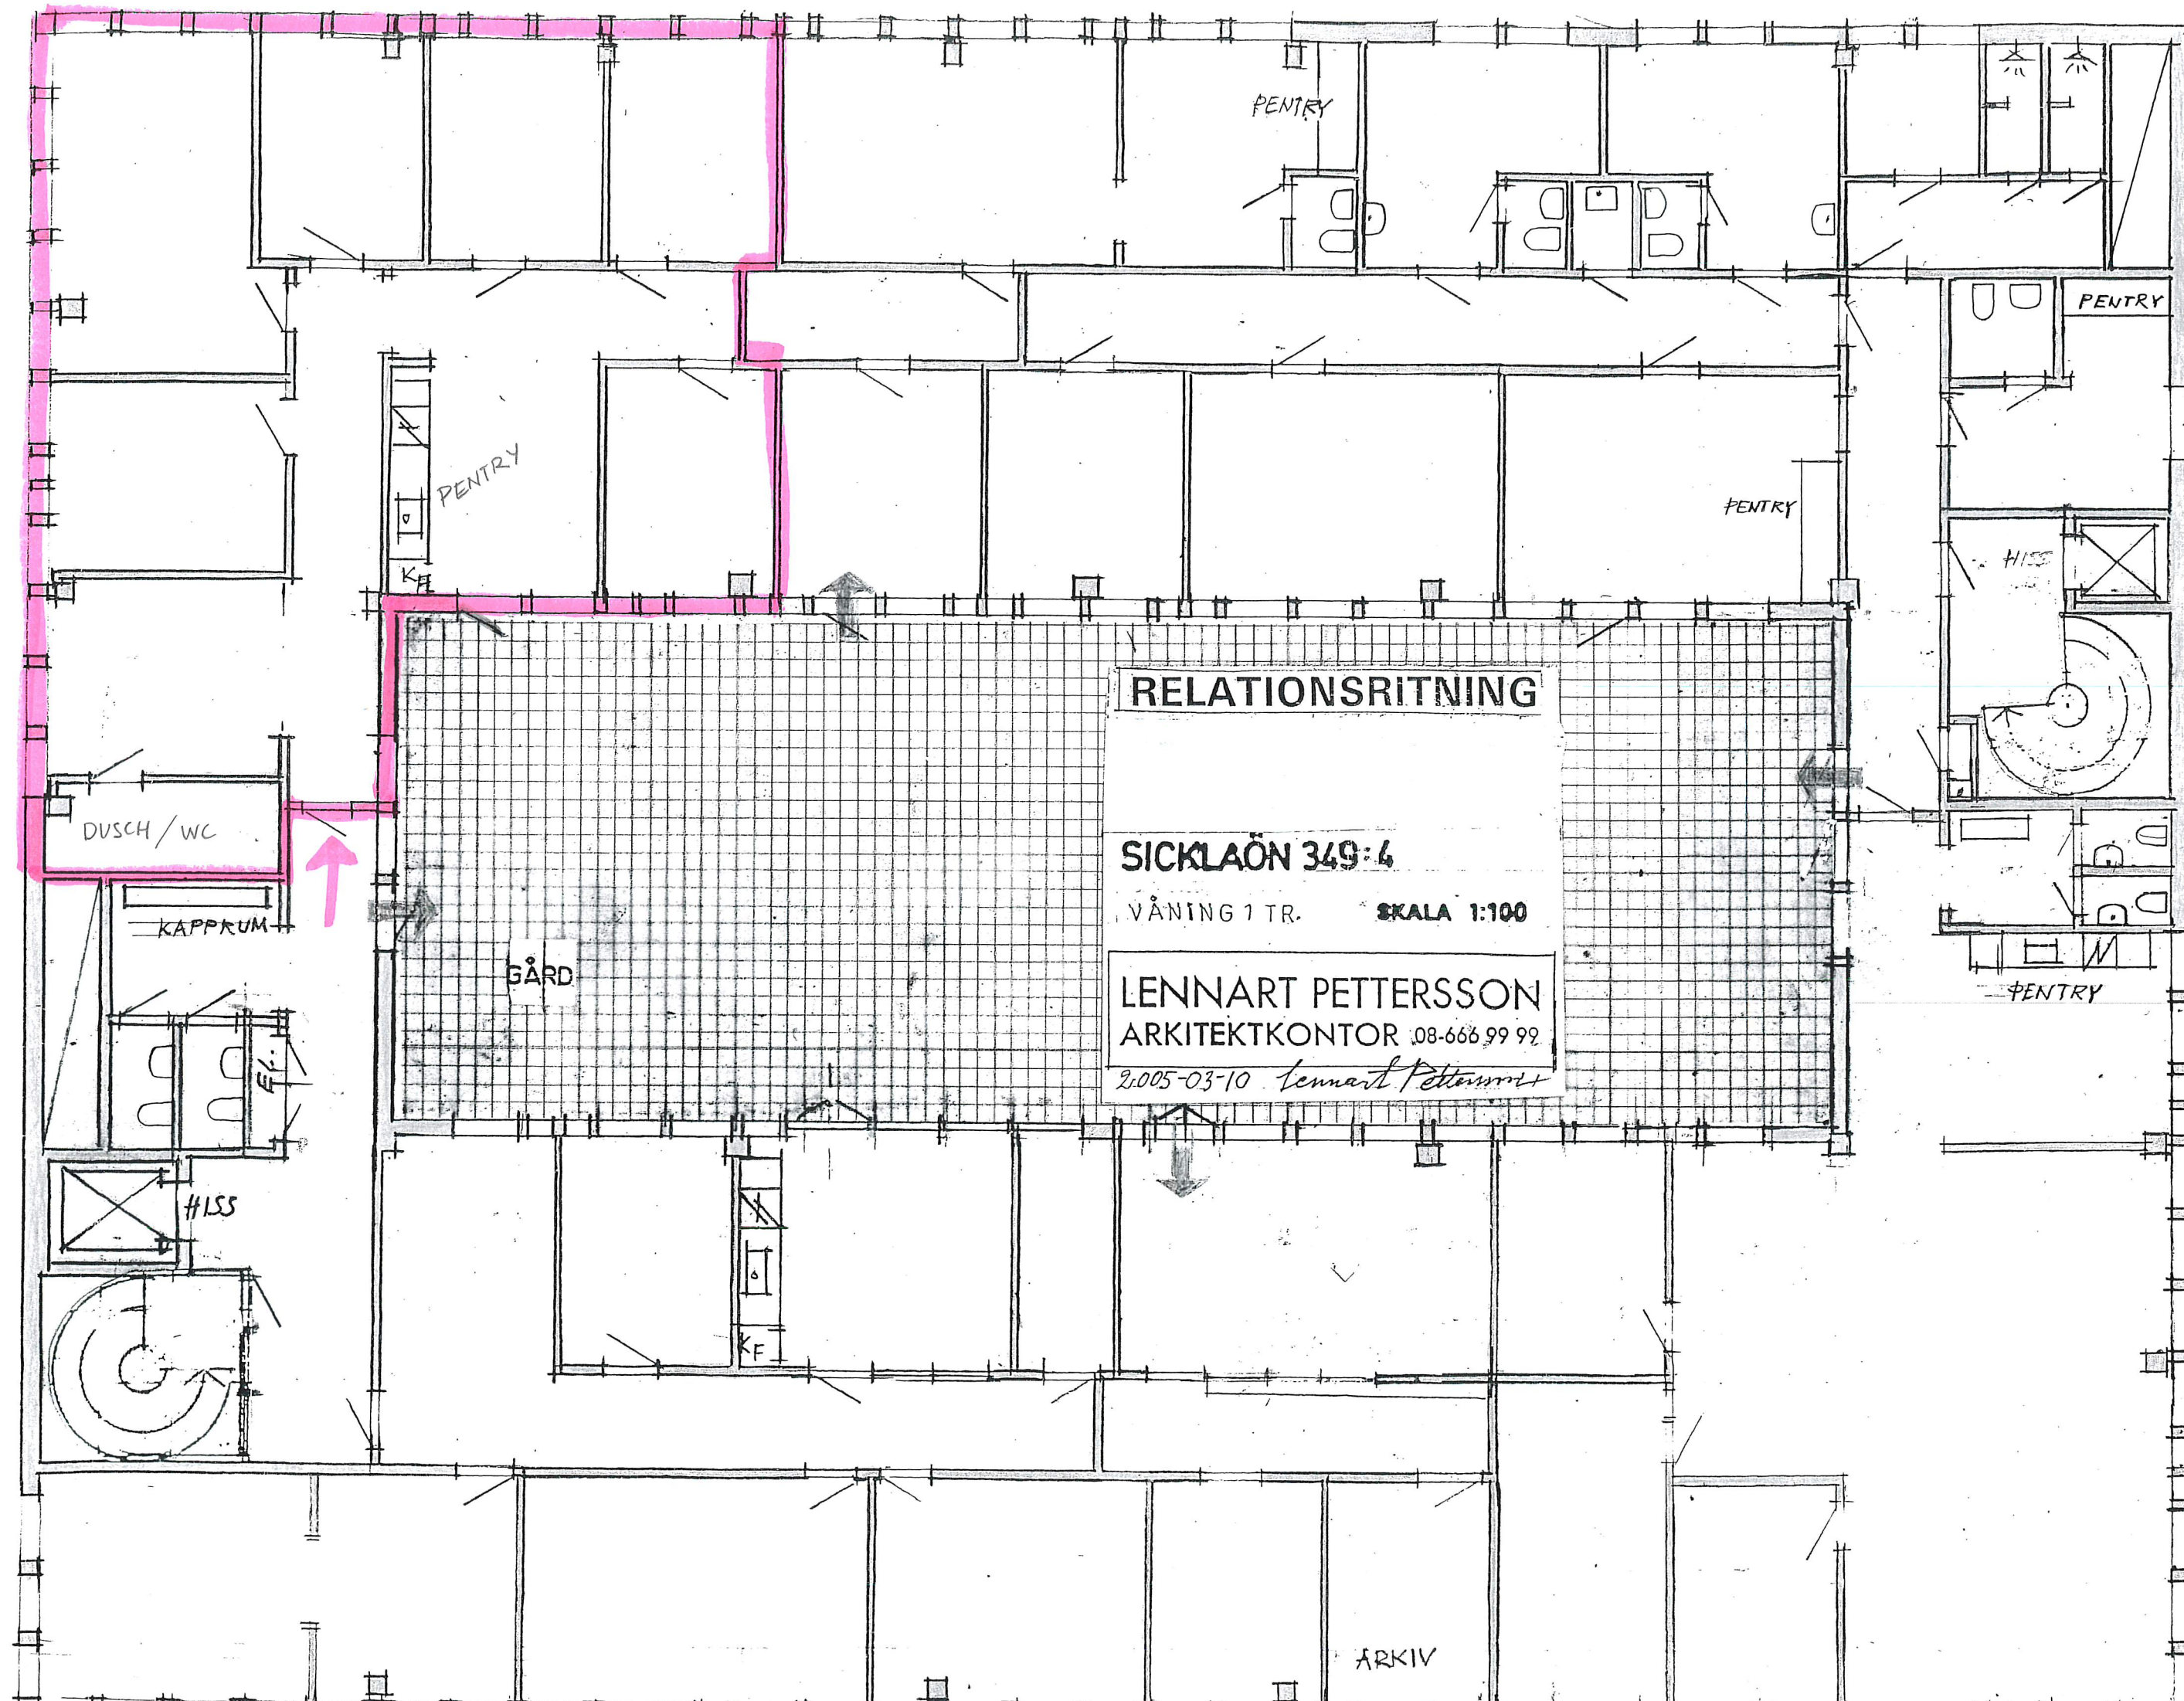

RELATIONSITNING

SICKLAÖN 349:4

VÅNING 1 TR. SKALA 1:100

LENNART PETTERSSON
ARKITEKTKONTOR 08-666 99 99

2.005-03-10 *Lennart Pettersson*

DUSCH/WC

KAPPRUM

GÅRD

HISS

ARKIV

PENTRY

PENTRY

PENTRY

PENTRY

HISS

PENTRY