



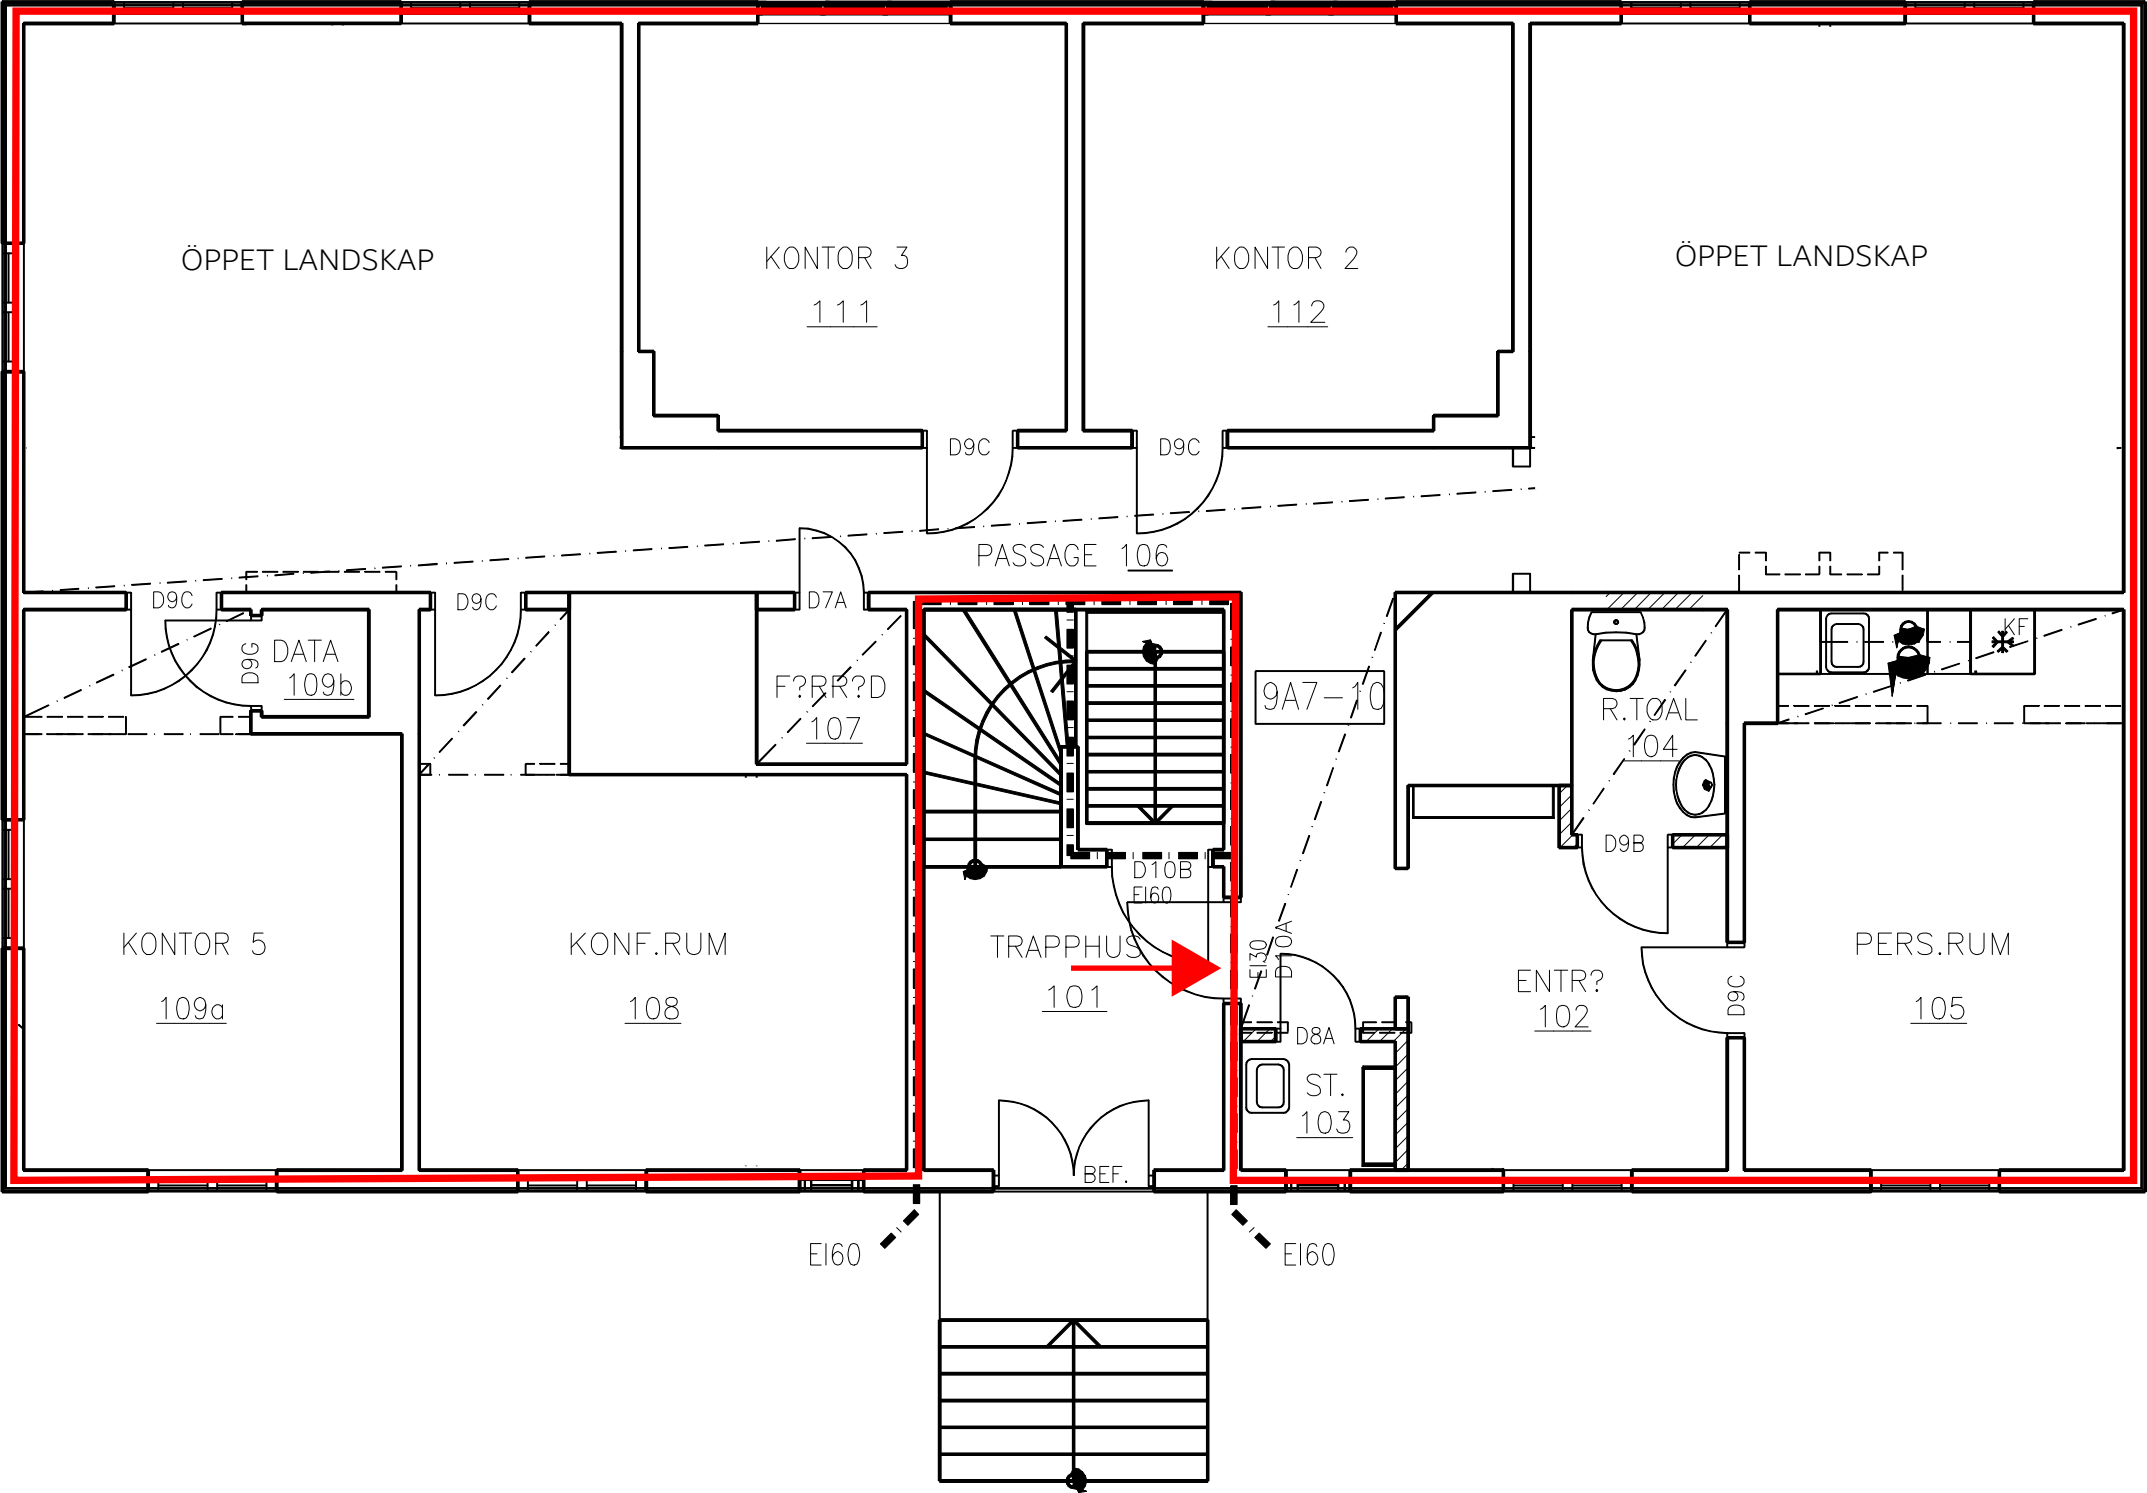

SKALA 1:100

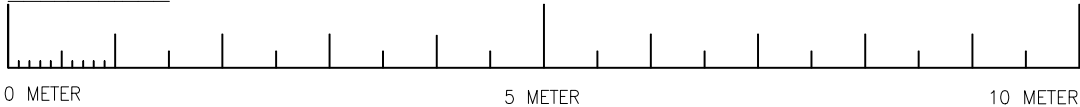

REVIDERING AVSER:	RELATIONSRTNING	DAT. 16/4 1999	SIGN. HP
KV ENBUSKEN 22 LINK?PING. OMR?DE 9 HUS A7		ARBETSNUMMER:	RITINGSNUMMER:
PLAN 1. BOTTENPLAN		9808	A-001
SKALA 1:100	DATUM: 25 / 11 1998	RITAD: HANS PETERSSON	GRANSKAD: OLLE JOHNSON
LINK?PINGS BYGGKONSULT AB		582 19 LINK?PING	
NYGATAN 25		TELEFON: 013 - 31 17 70	