





2014-01-29 SL

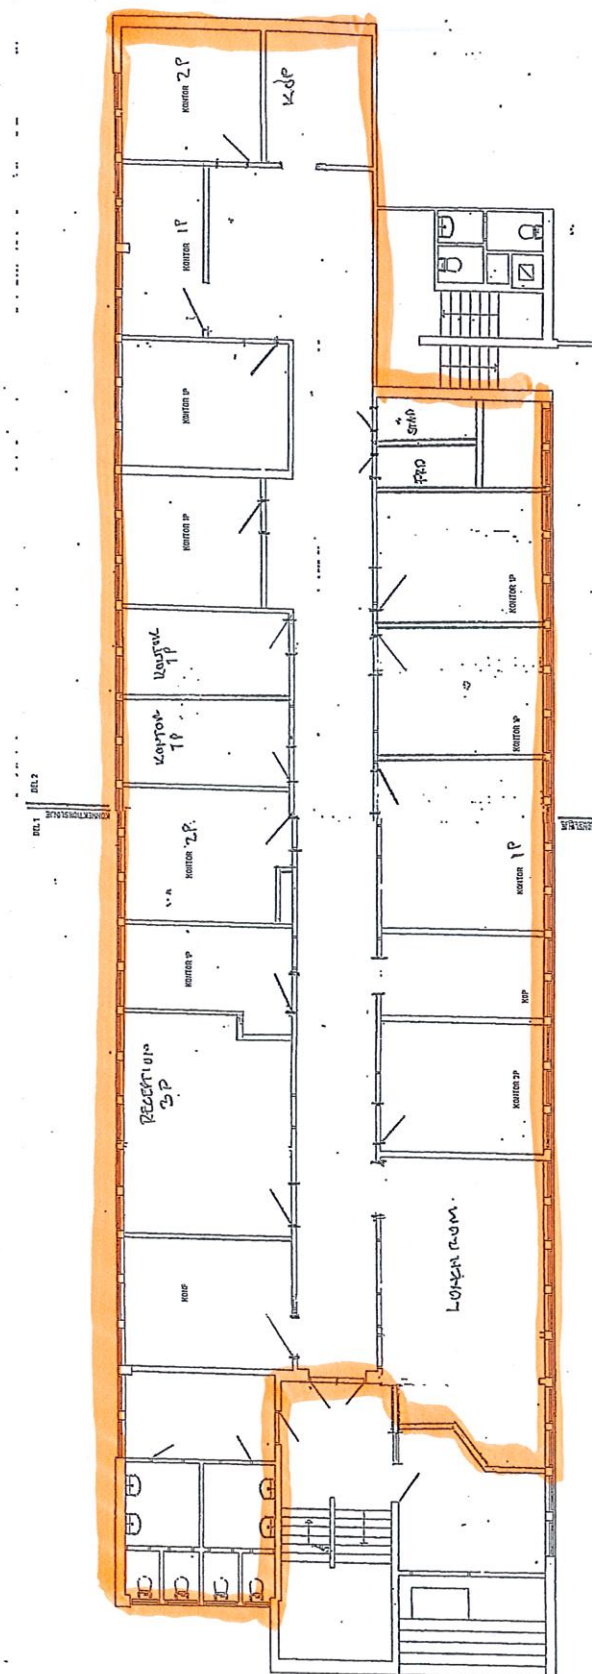

ORSS! E05444

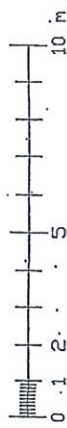

Handwritten signature or initials in blue ink.

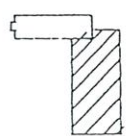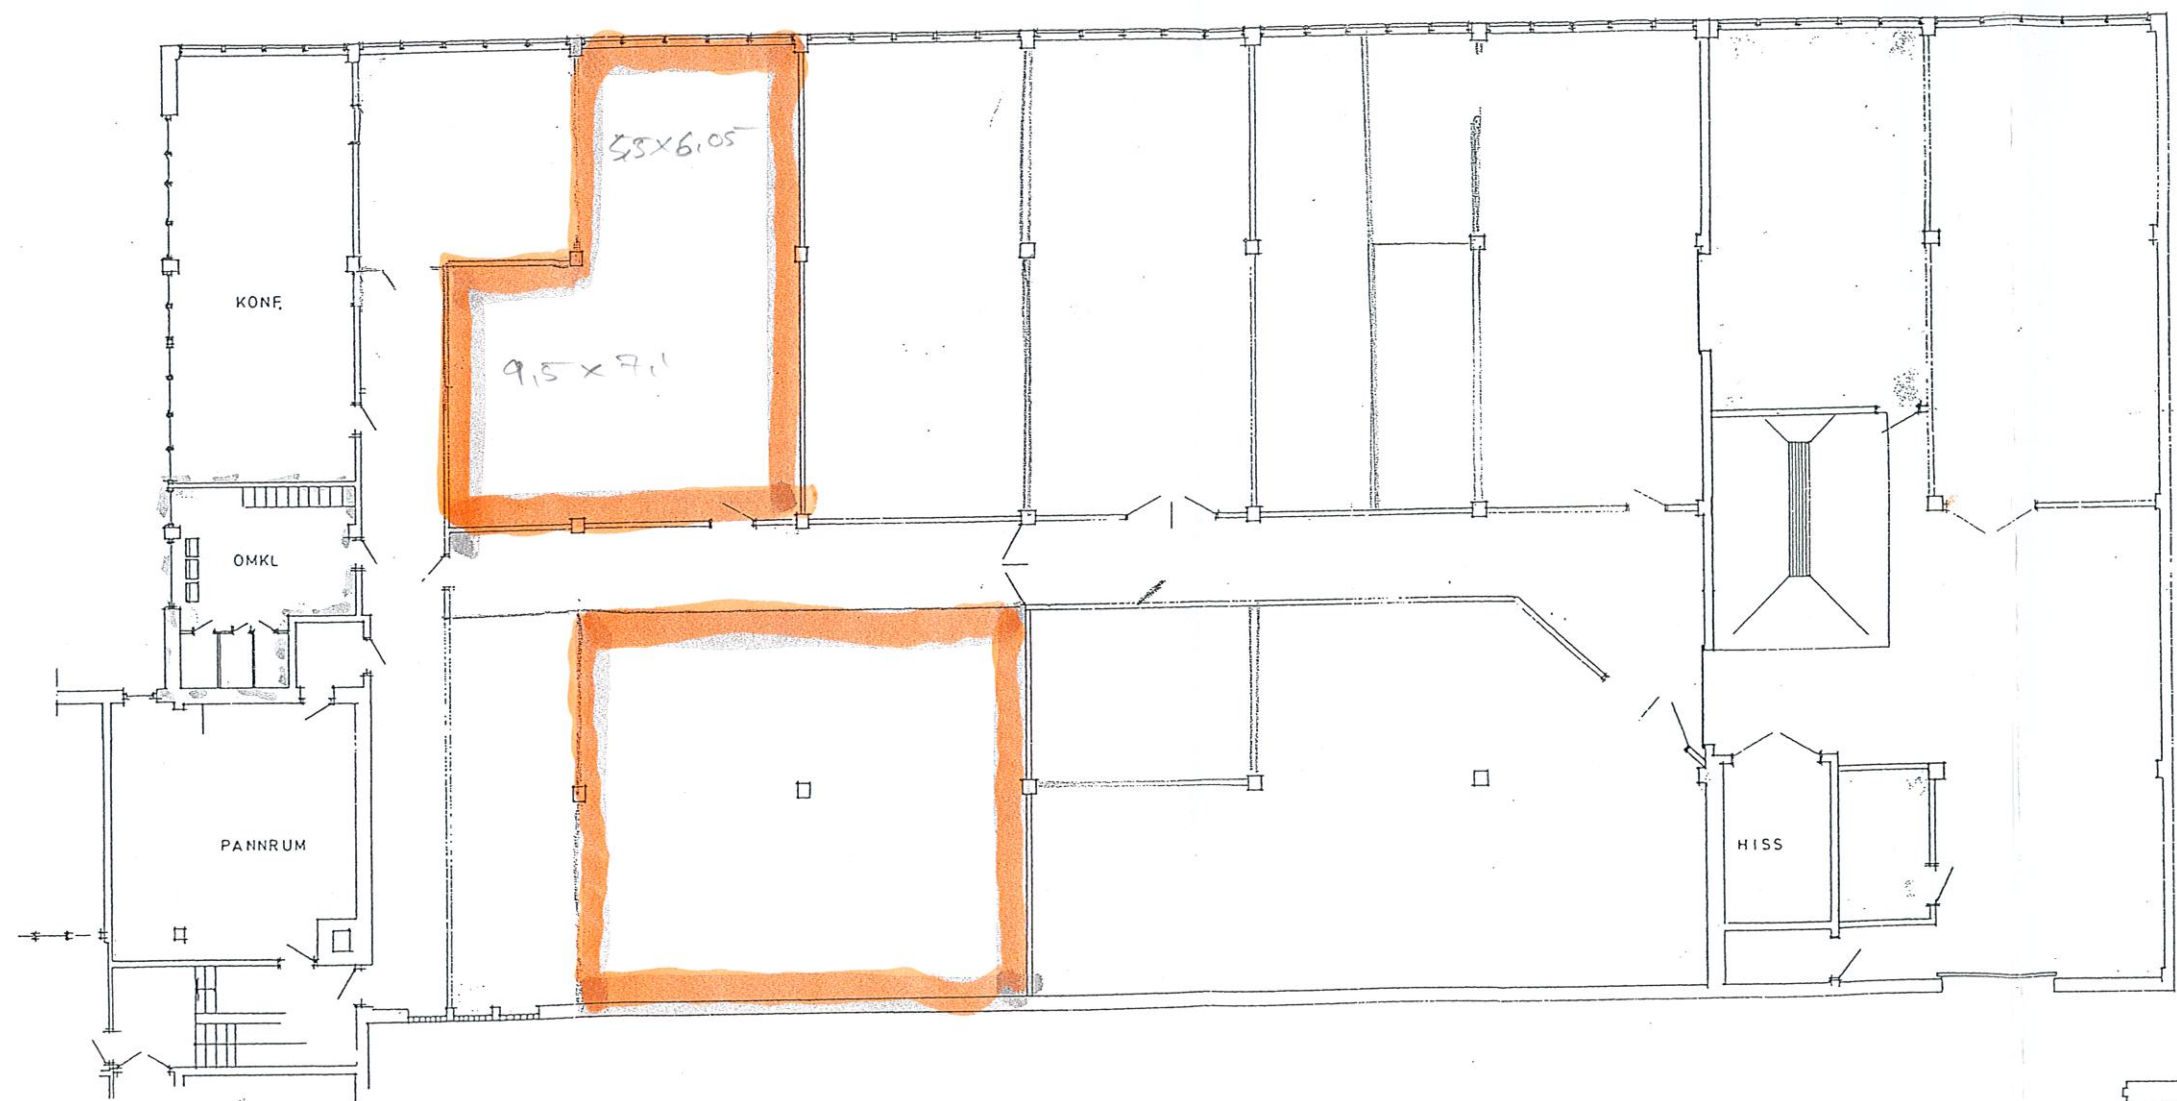

KV. KRAKSTÖREN NR 1
HAGSÄTRA
LAGER PLAN KV
STALM 1994 05 05

[Handwritten signature]
[Handwritten initials]