



PLAN 7 VIND

OKTAGON PLAN 7

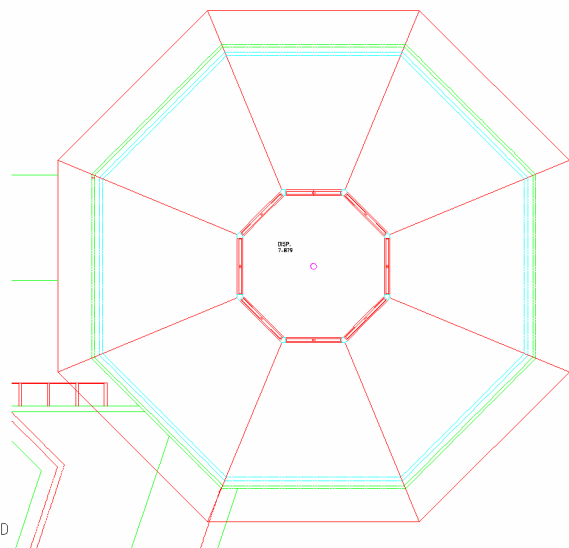

DEL AV TAKPLAN 7 VIND

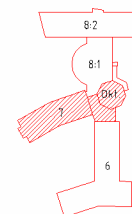

A	Allmän revidering	MMe	20030401
Rev.	Revideringen avser	Sign.	Datum

## RELATIONSRTNING

# Soft Center

# 7

RONNEBY

Plan 7

Ritad	Datum	Skala	Ritn.nr	Rev.
Fogelberg	1999	1:200	A:770	A